

PLAN SHOWING THE PROPOSED RESIDENTIAL BUILDING TO BE CONSTRUCTED
 IN OLD S. NO 78/1A, NEW NO 78/89 AT PILLAYAR KOIL STREET PERUNGUDI, MADRAS
 IN ST. THOMAS MOUT PANCHAYAT UNION. OWNER SRI. S. MADHAVAN

SCALE 1:100 (1" = 8'0")

Planning Permit No. **A/462/90**

APPROVED

SUBJECT TO THE CONDITIONS IN
 THIS OFFICE LETTER

No. **A/24578/89** REFERENCE

FOR MEMBERS SECRETARY
 MADRAS METROPOLITAN
 DEVELOPMENT AUTHORITY
 MADRAS - 600 008.

- D. DOOR PANELLED COUNTR WOOD 3'0" x 6'6" (0.91 x 1.98)
- DI DOOR SETTED " 2'6" x 6'6" (0.76 x 1.98)
- V. VENTILATOR " 3'0" x 2'0" (0.91 x 0.61)
- 3'0" x 4'0" (0.91 x 1.22)

classification for


AREA OF CONSTRUCTION

AREA OF PROPOSED CONSTRUCTION


AREA OF SITE

AREA OF OPEN SPACE


281 SFT (26 SQ. M)
 1201 SFT (111.62 SQ. M)
 920 SFT (85.50 SQ. M)

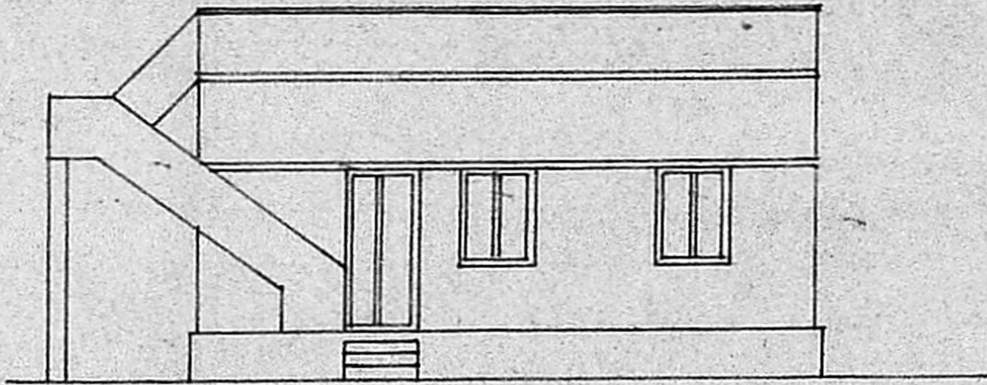


ELEVATION

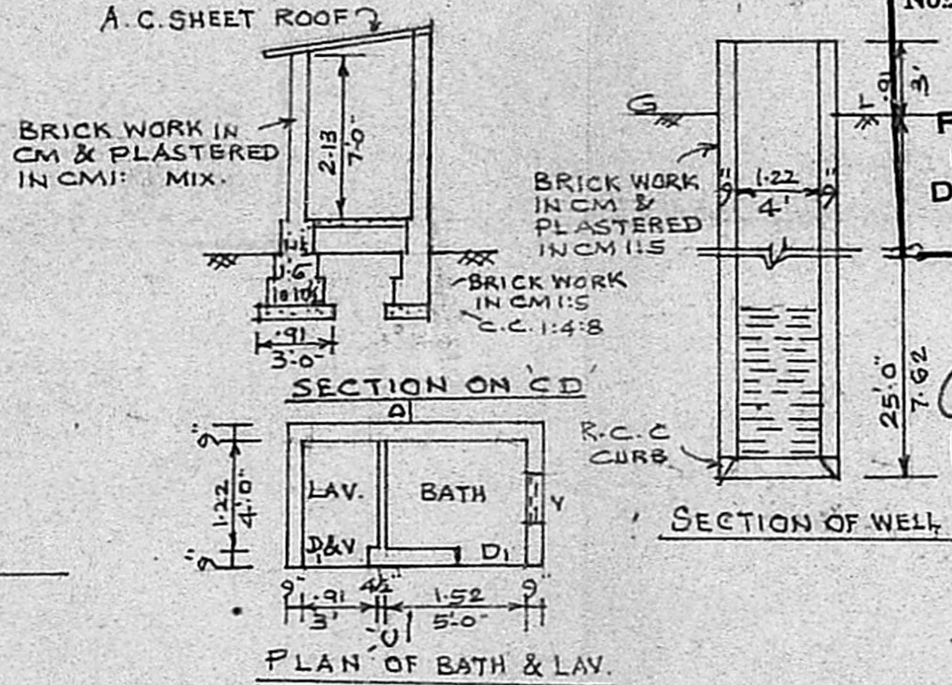


PLAN OF BATH & LAV.

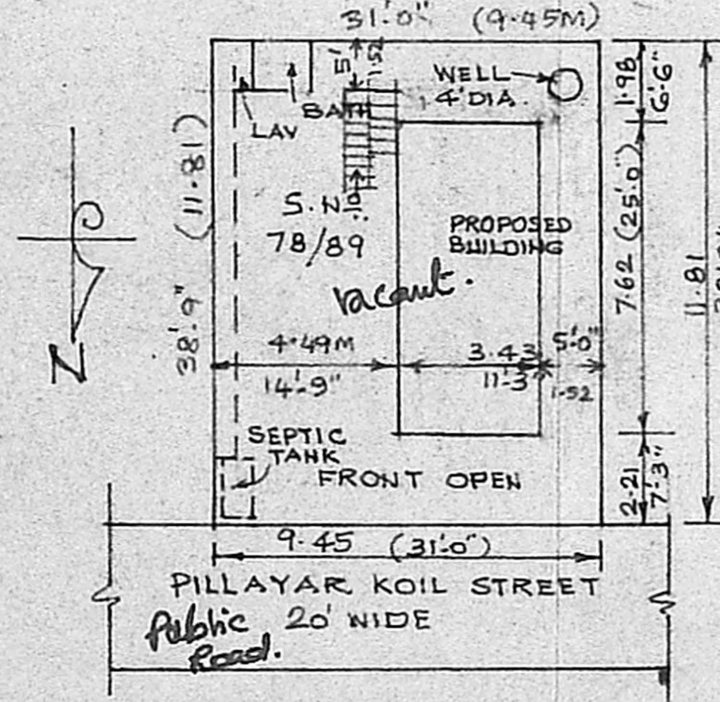


SITE PLAN
 SCALE 1" = 16' (1:200)
 PROPOSALS ARE SHOWN IN RED.

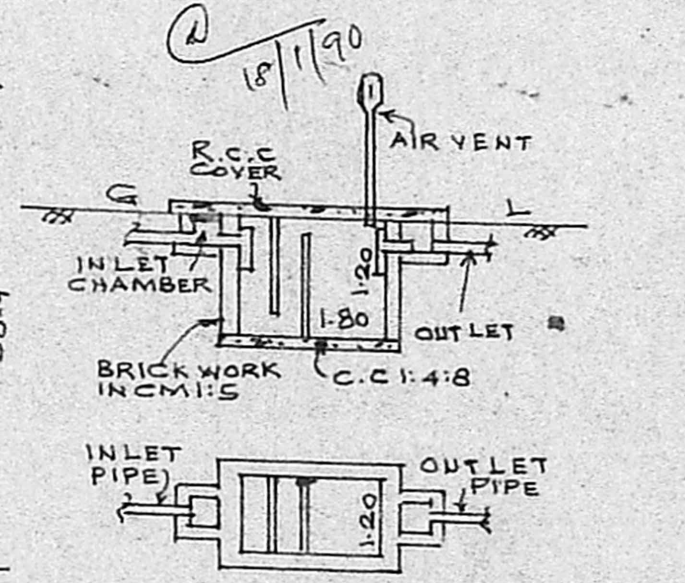

DETAILS OF SEPTIC TANK.

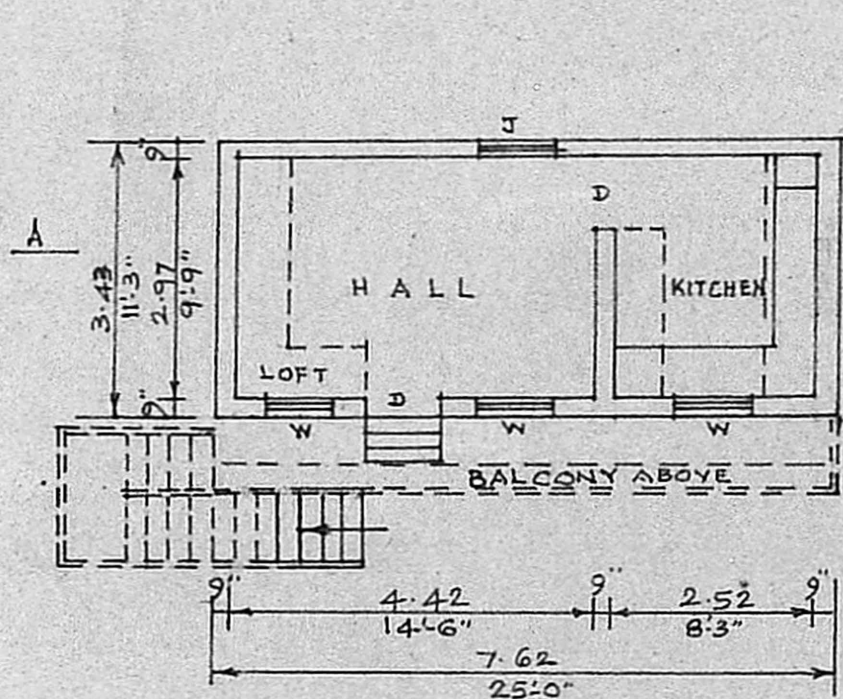

PLAN

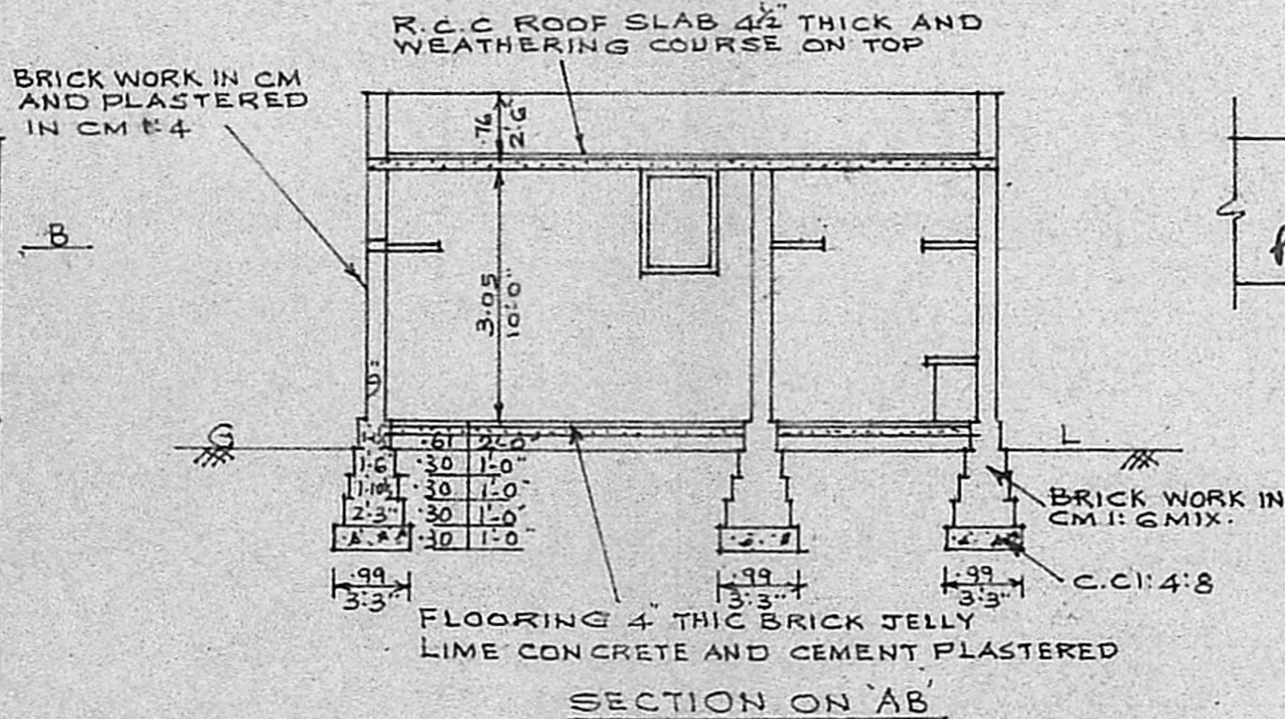

SECTION ON AB

R. Mohan Rao
 Phone: 440782

R. Mohan Rao, D.C.E.,
 LICENSED SURVEYOR
 Corporation of Madras
 REG No: 14
 AMBATTUR TOWN SHIP
 ALANDUR MUNICIPALITY
 Consulting Engineer & Contractors
 Office: 15, Madhey Road
 T. NAGAR, MADRAS-600 017

OWNER
S. Madhavan