PROPOSED CONSTRUCTION OF SHOPS IN S.No 199/1A2, No 2, VANDALUR VILLAGE, CHENGALPATTU TALUK & DISTRICT.

SCALE :- 1:100 ; 1" = 8'-0"

NOTE :-

1. PROPOSALS SHOWN IN RED
2. PLOT SHOWN IN YELLOW
3. ROAD SHOWN IN GREEN
4. AREA OF THE PLOT - 94.24 m²; 1022 SFT.
5. AREA OF THE CONSTRUCTION - 14.40 m²; 155 SFT
6. LAND WITH BUILDING TAKEN BY NATIONAL HIGHWAYS SHOWN IN BROWN

REFERENCE

R.S. ROLLING SHUTTUR 10'×8', 3.0m

A/1103/89

Planning Permit No.

APPROVED

Subject to the conditions in this office letter.


31.10.89

FOR MEMBER SECRETARY
MADRAS METROPOLITAN DEVELOPMENT AUTHORITY

Inspected on 13.9.89.
(1) Vacant site.
(2) Shops & G.S.T. road & residential houses
(3) Surrendered portion of land for Chandra Industries & Aruna Farms

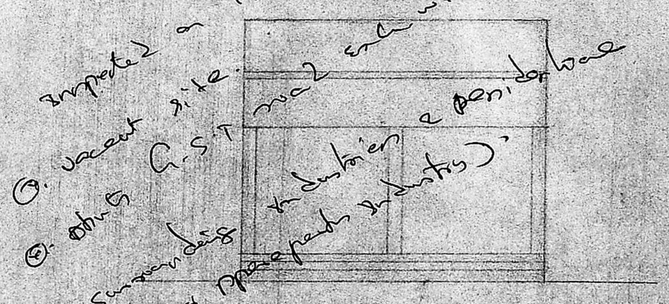

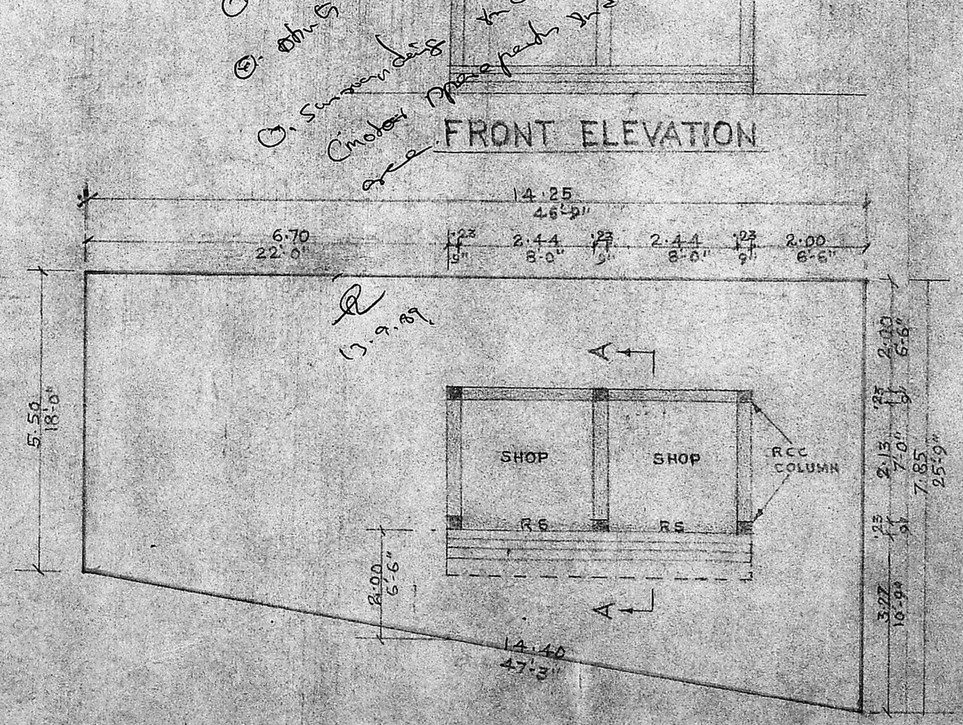

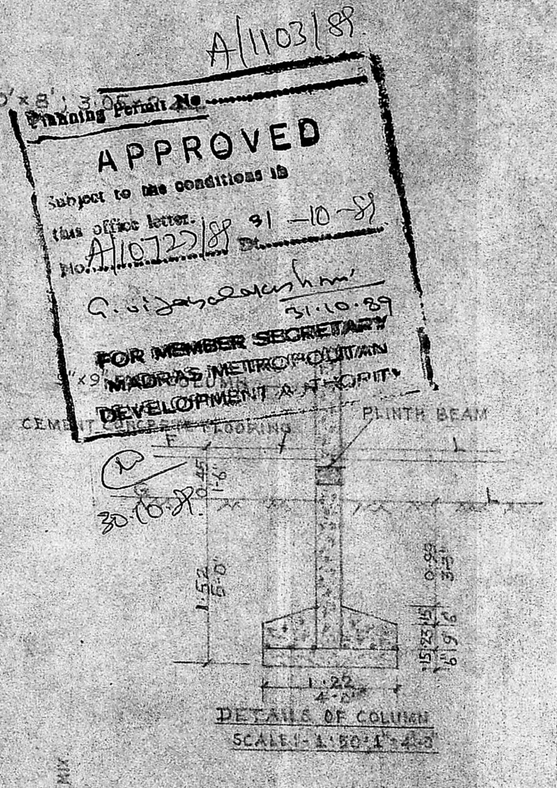

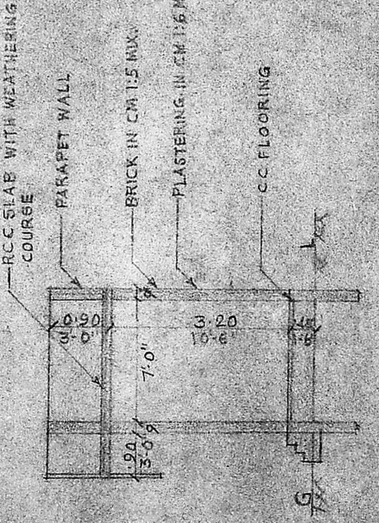

Office Copy

SITE PLAN

CHENGALPATTU TALUK
VANDALUR VILLAGE
S.No. 199/1A2
SCALE :- 1"=33'-0" ; 1:400

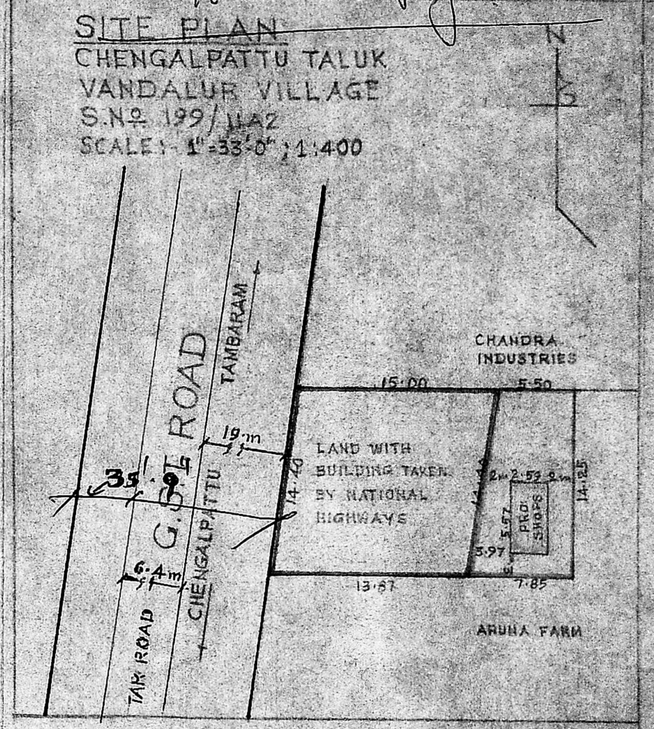

KEY PLAN

NOT TO SCALE

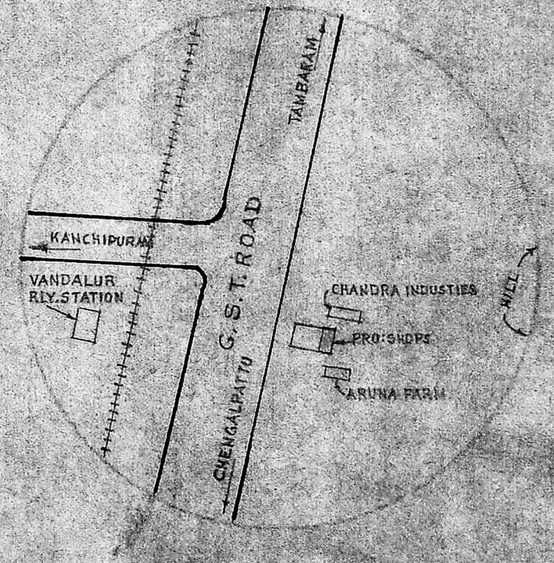

S.C. JAYAKARAN JAMES
LICENSED SURVEYOR
CHENGALPATTU MUNICIPALITY
14 KESAVANAR STREET,
CHENGALPATTU.

OWNER